


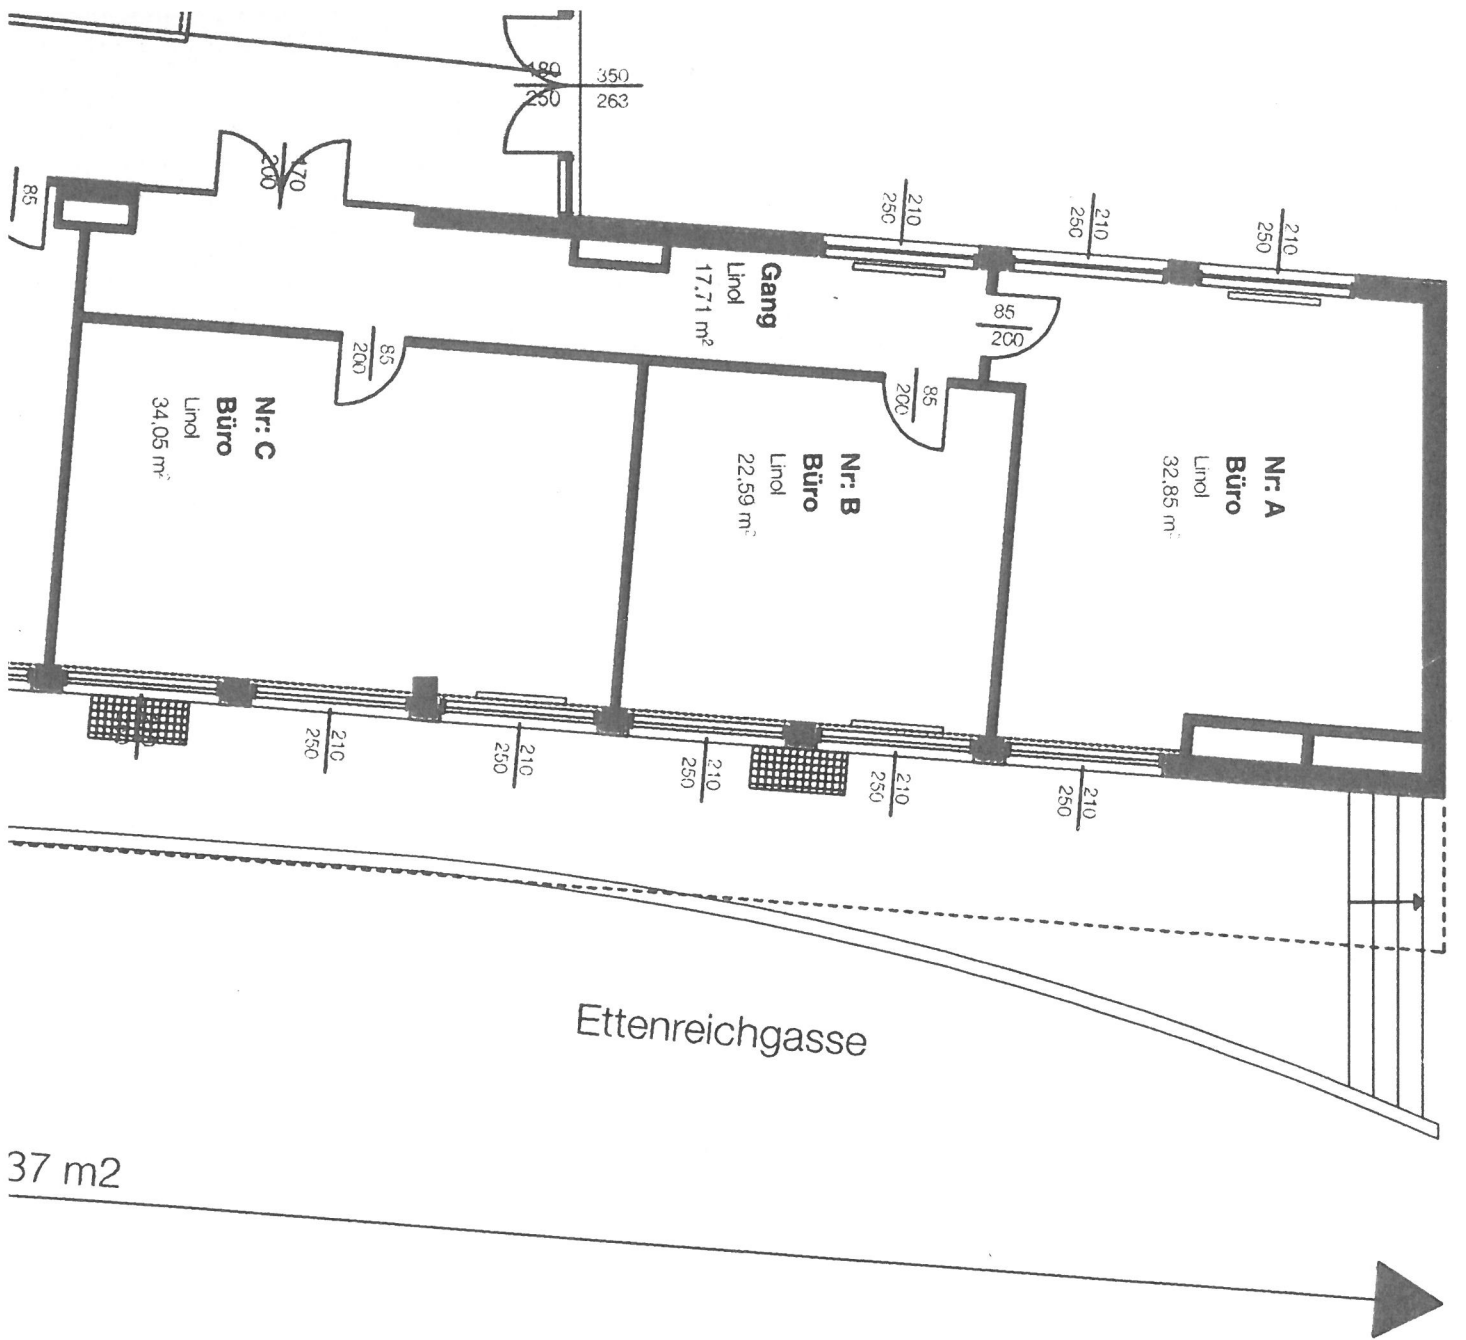

37 m2