


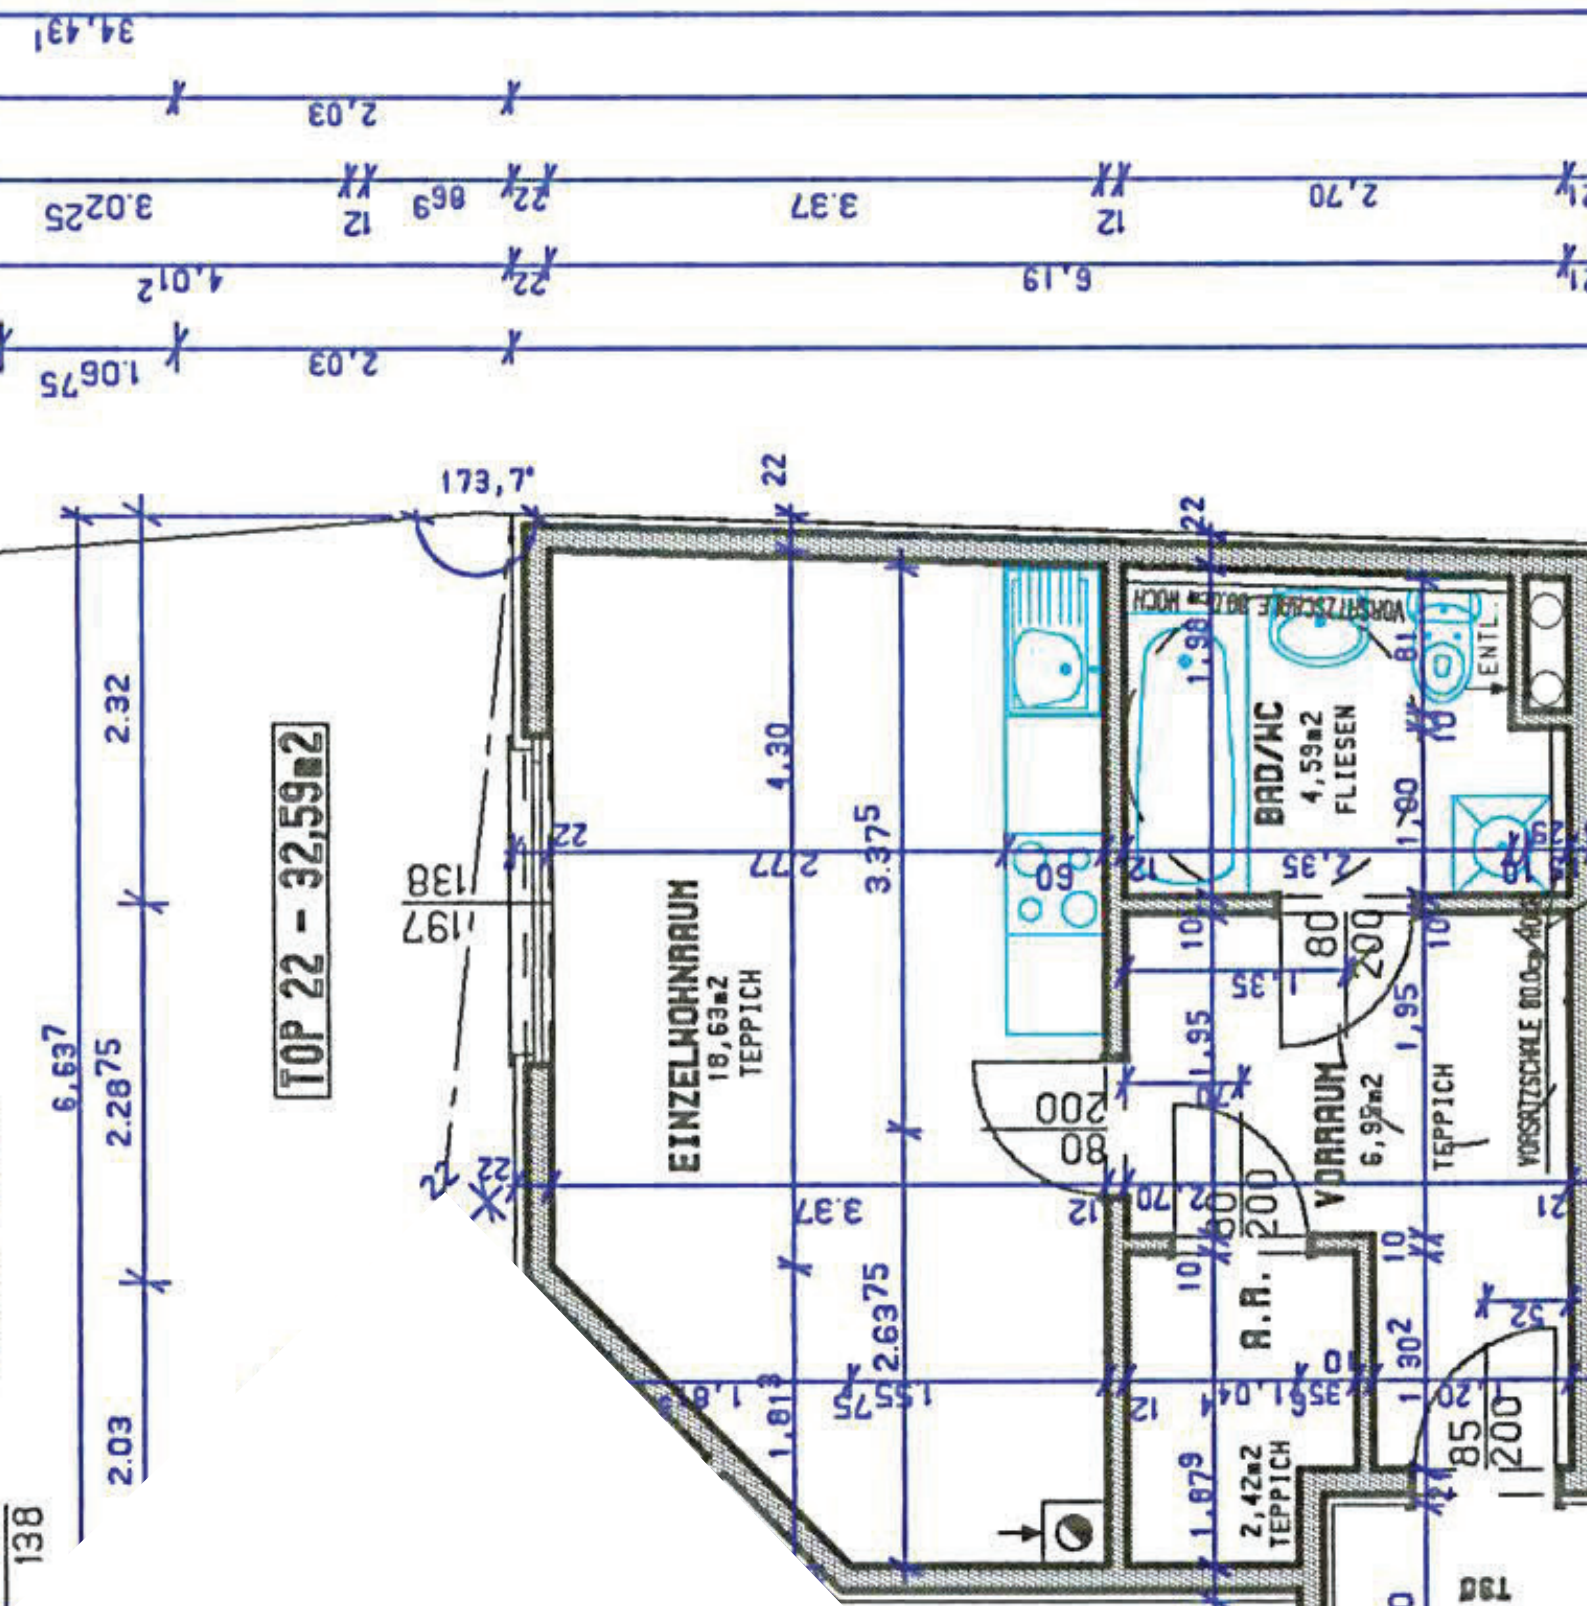

138

061